




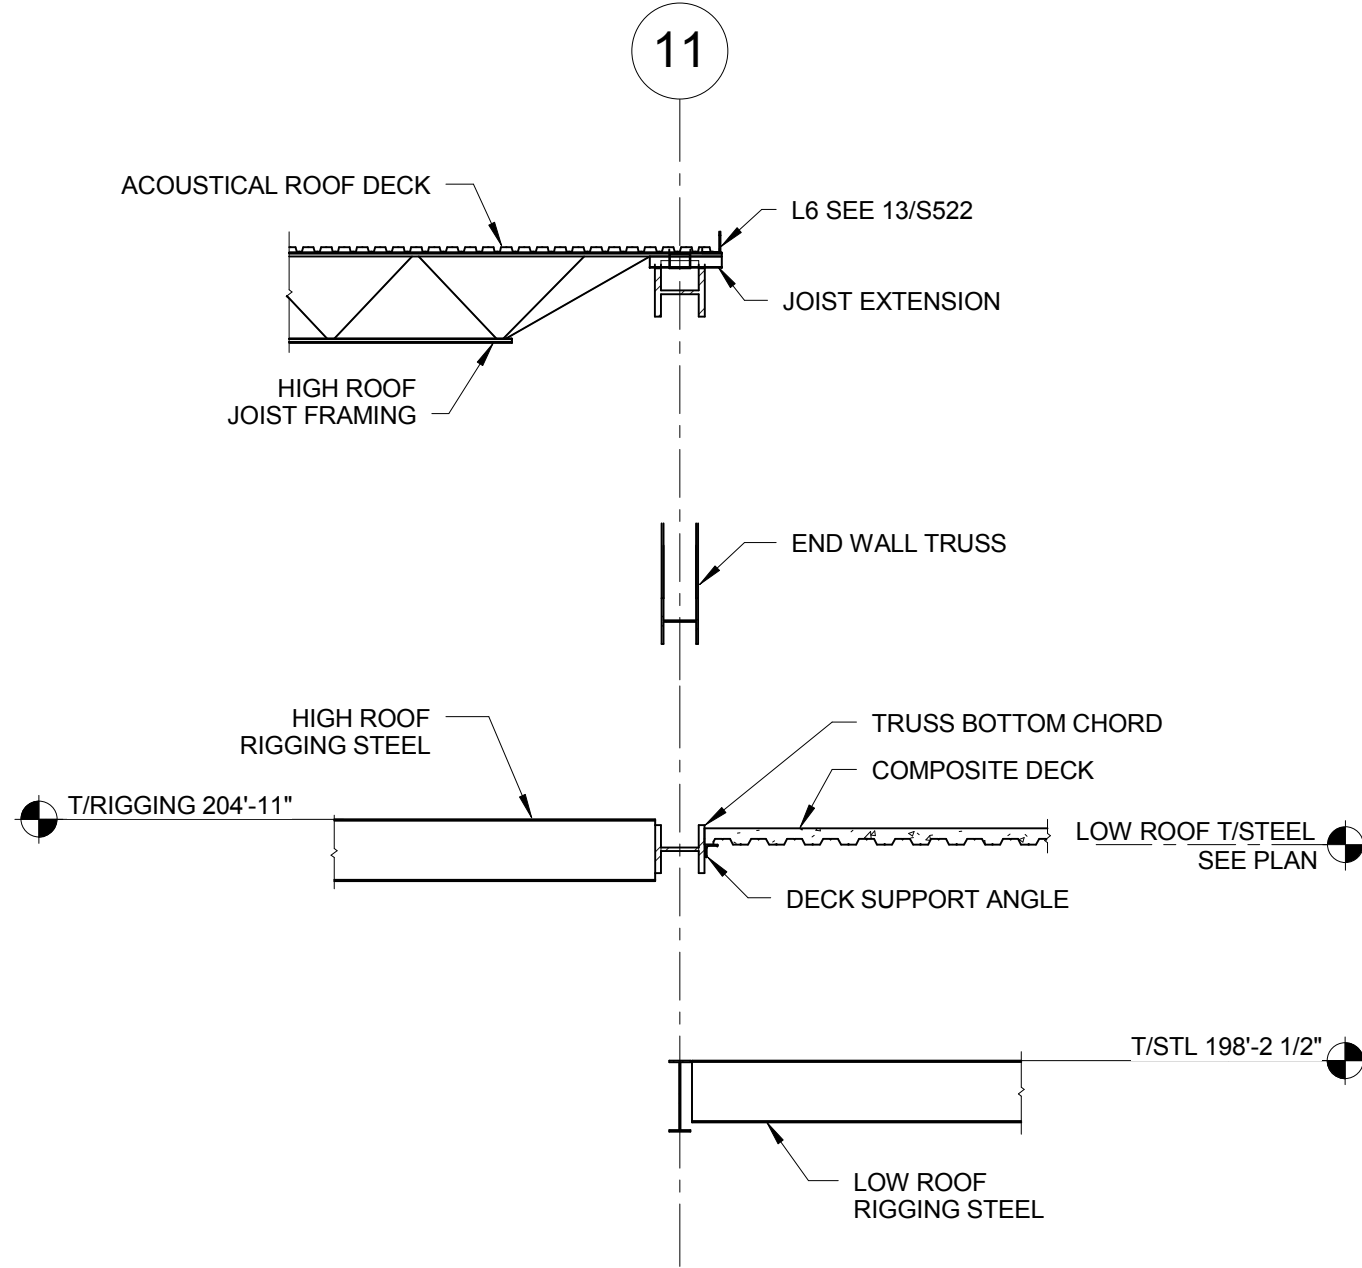


4 RIGGING ELEVATION CHANGE

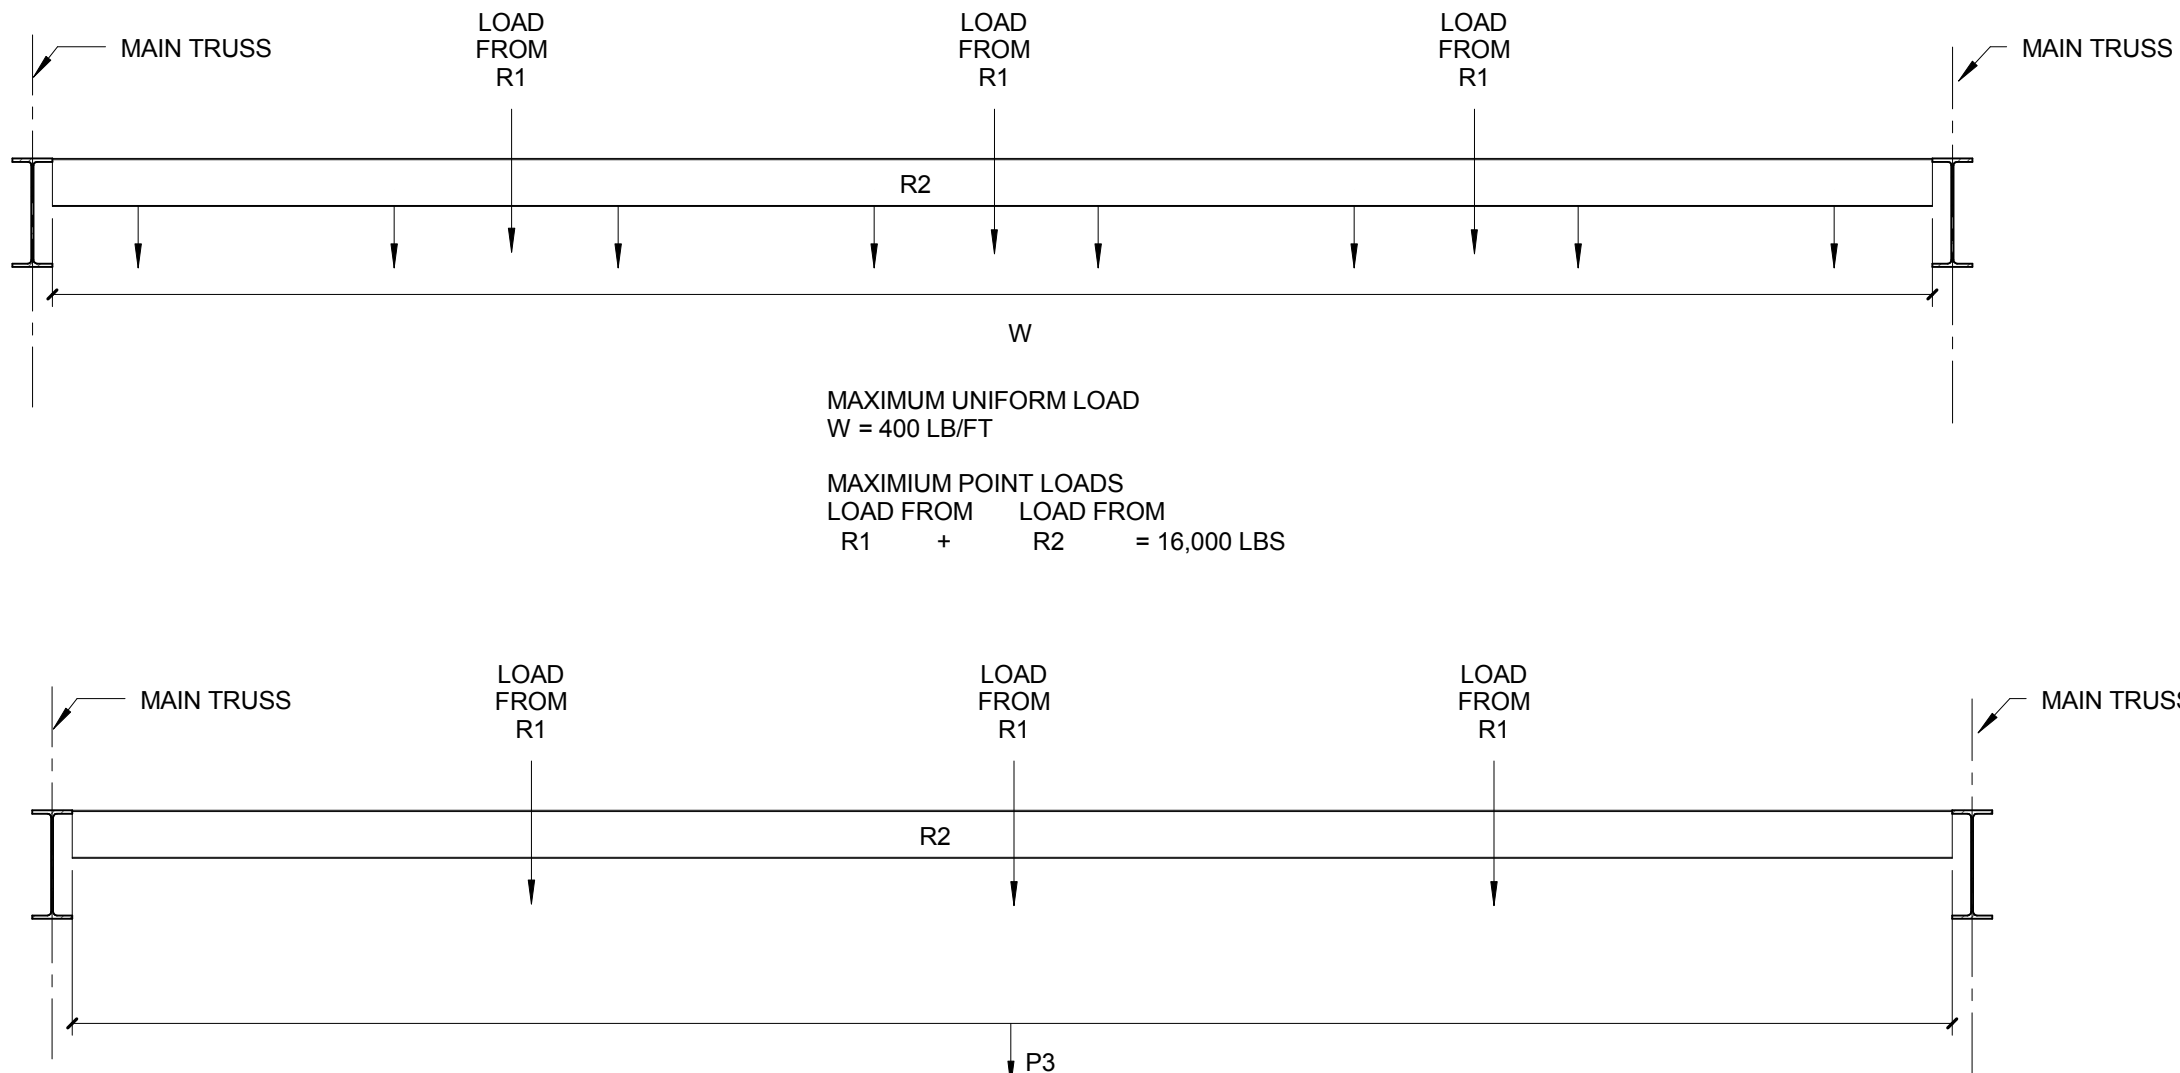

3 R2 BEAM LOADS

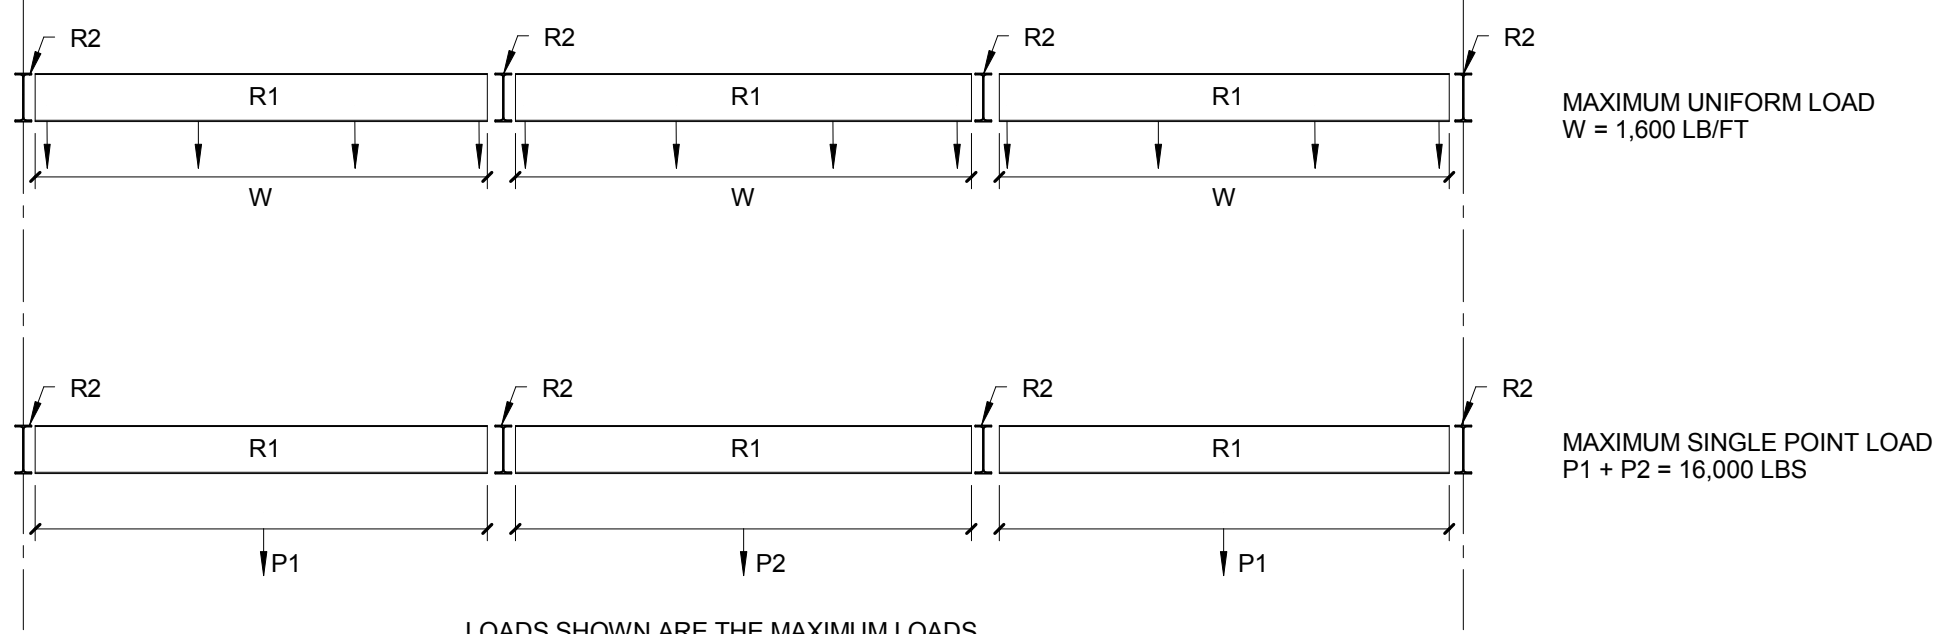

2 R1 BEAM LOADS

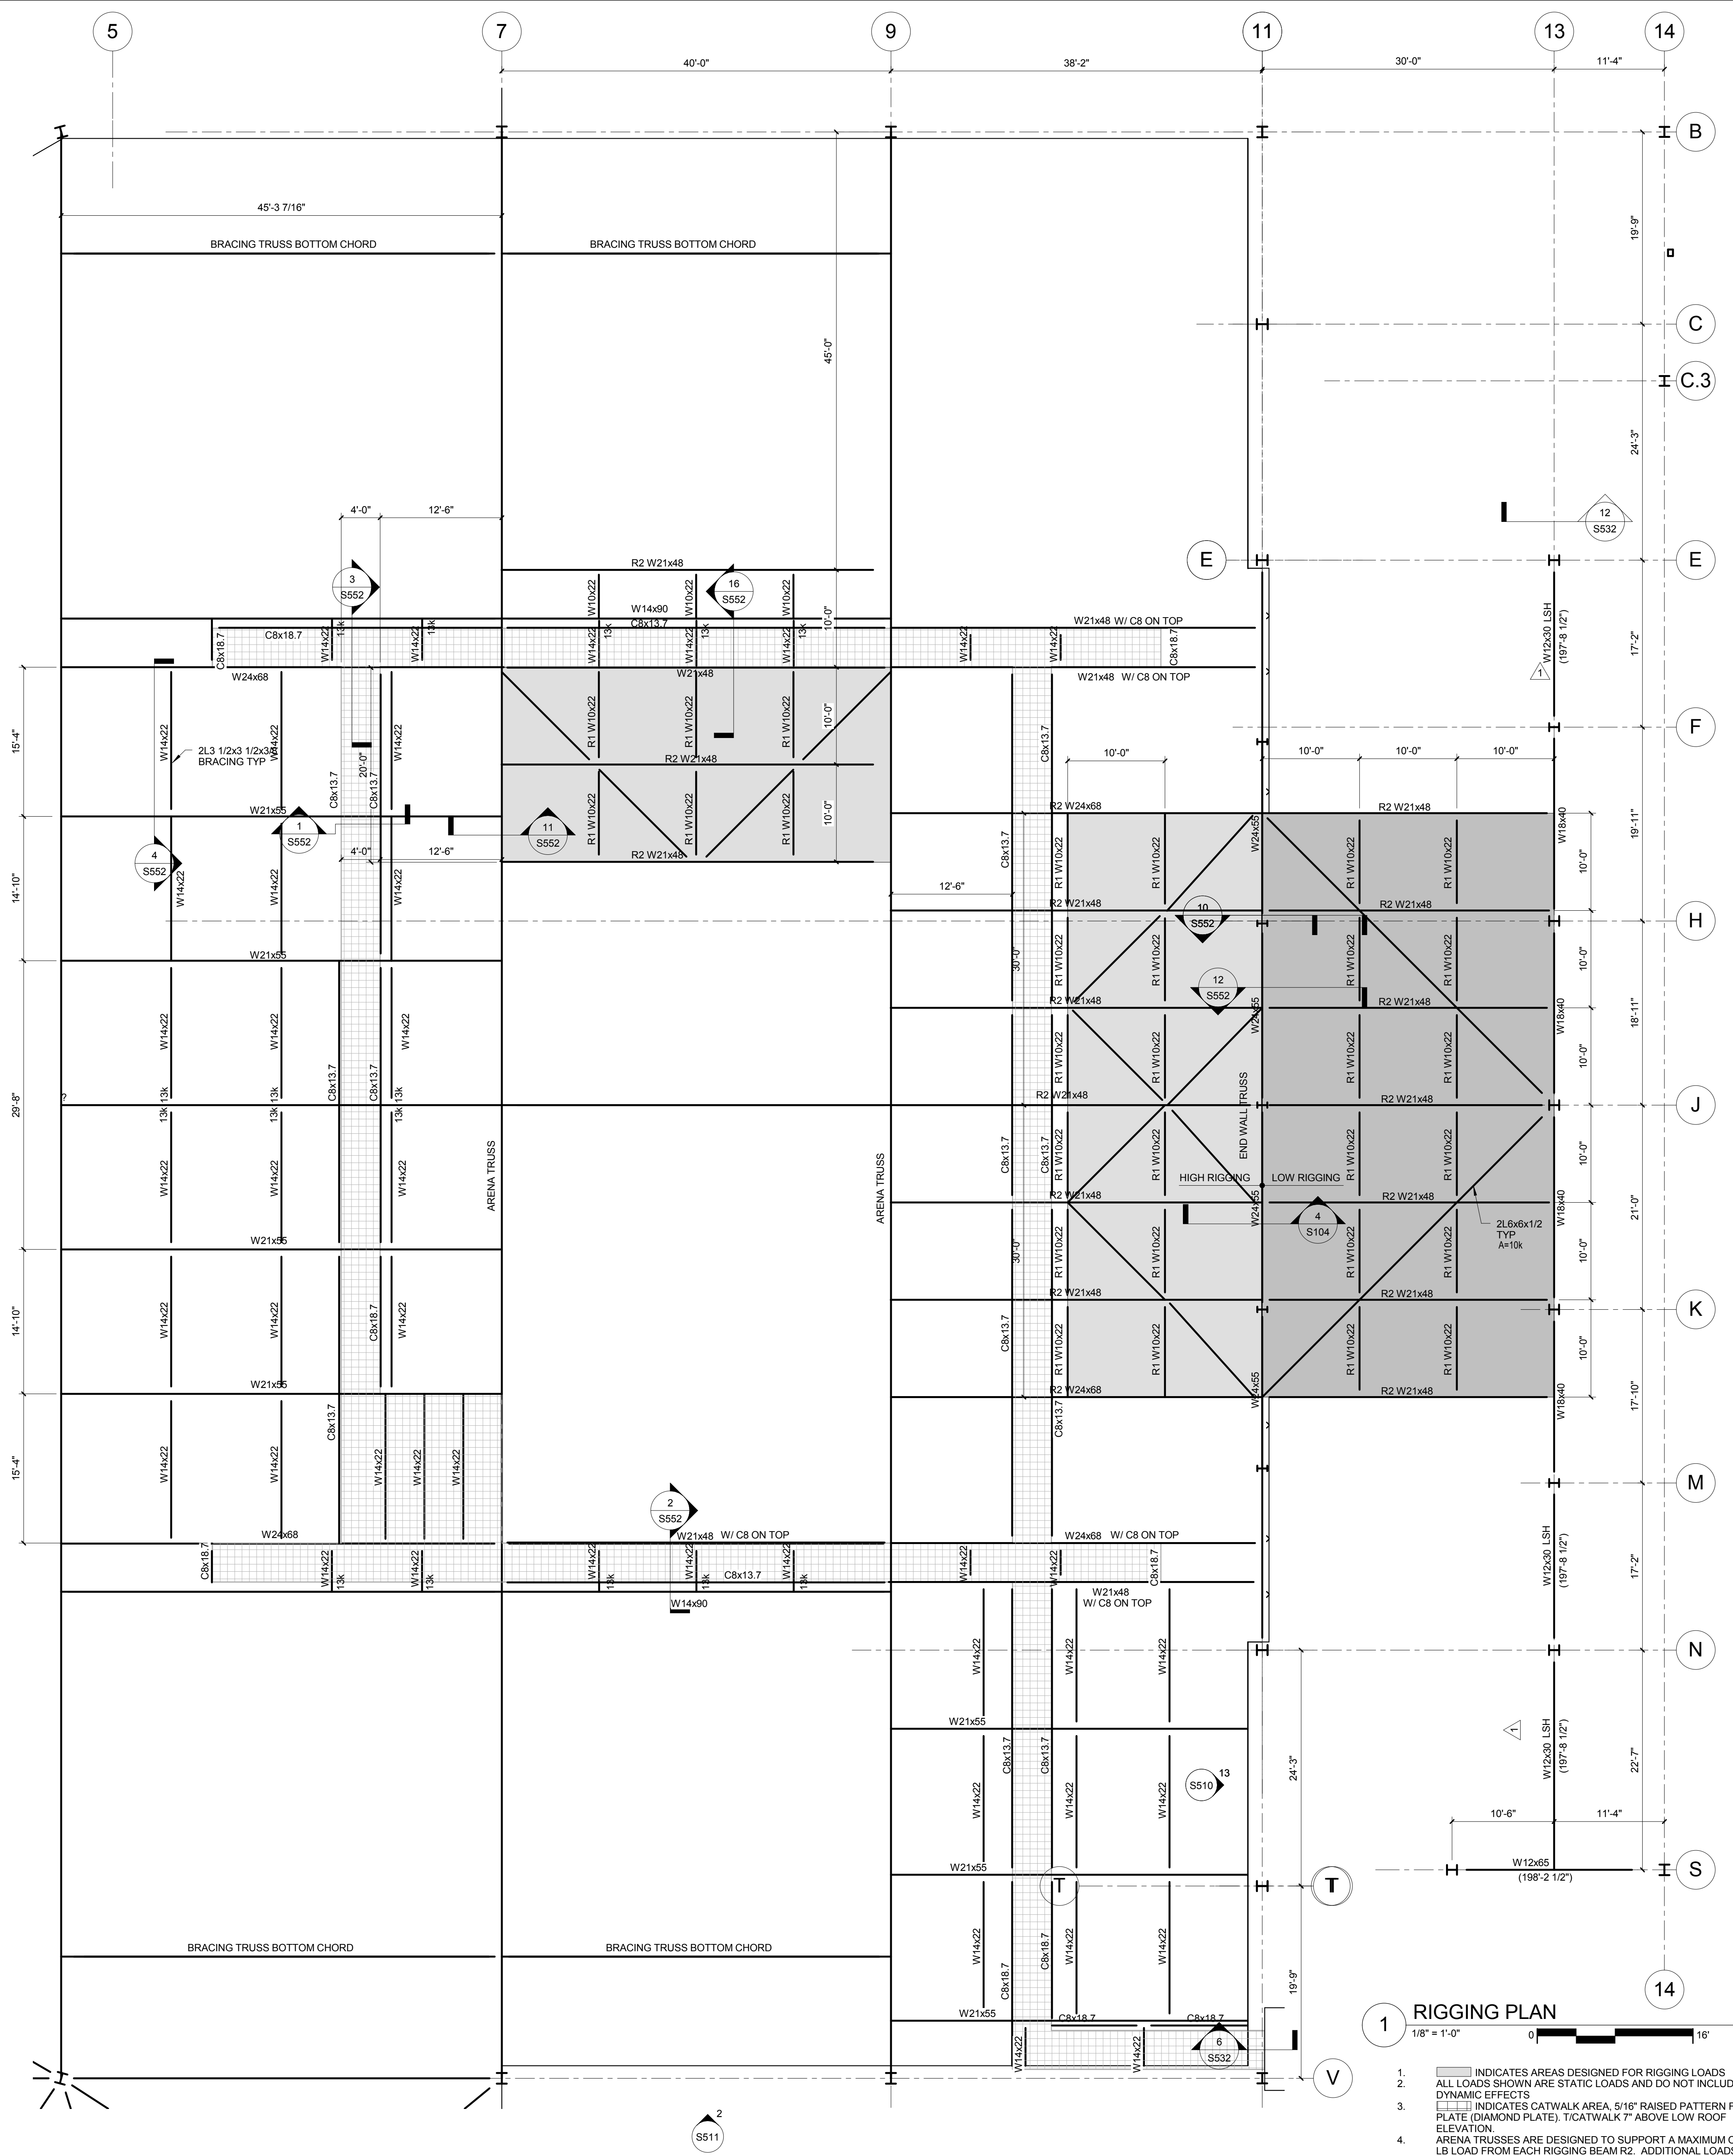

1 RIGGING PLAN

- INDICATES AREAS DESIGNED FOR RIGGING LOADS.
- ALL LOADS SHOWN ARE STATIC LOADS AND DO NOT INCLUDE DYNAMIC EFFECTS.
- INDICATES CATWALK AREA, 5/16" RAISED PATTERN FLOOR PLATE (DIAMOND PLATE), T/CATWALK 7" ABOVE LOW ROOF ELEVATION.
- ARENA TRUSSES ARE DESIGNED TO SUPPORT A MAXIMUM OF 16,000 LB LOAD FROM EACH RIGGING BEAM R2. ADDITIONAL LOADS APPLIED TO THE TRUSSES ARE NOT TO EXCEED THE MAXIMUM LOAD AS APPLIED BY REACTIONS FROM R2.
- CATWALK SUPPORT CHANNELS C8x13.7 REQUIRE A MINIMUM OF 2 SPANS, C8x18.7 IS REQUIRED FOR SINGLE SPANS.

EVENT CENTER  
AND ARENA


UMBC Project No.: PRF#15-101  
UMB Project No.: 14-338  
A/E Project No.: 04469.00  
CM Project No.: 140610

PRIME A/E:

CANNONDESIGN

250 West Pratt Street, Suite 2100  
Baltimore, Maryland 21201  
T: 410.234.1155  
F: 410.234.1160

STAMP/SEAL:

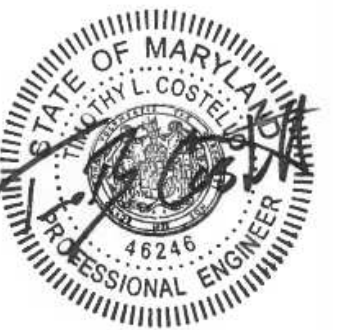

A/E CONSULTANTS:

Whitman Requardt & Associates LLP  
Civil  
801 South Caroline Street  
Baltimore, MD 21231  
443.224.1626

Mahan Rykiel Associates, Inc.  
Landscape  
800 Wyman Park Drive, Suite 100  
Baltimore, MD 21211  
410.235.6001

Columbia Engineering, Inc.  
Structural  
6470 Dobbin Road  
Columbia, MD 21045  
410.892.9970

Ernest Bland Associates, PC  
Architectural Sub-Consultant  
802 Silgo Avenue  
Silver Spring, MD 20910  
(301) 589.4811 Office

M Design Studio, LLC  
Interior Architecture / FF&E  
685 S. Washington St.  
Alexandria, VA 22314  
703.299.6280

CannonDesign  
Structural / Mechanical / Electrical /  
Telecommunications / Security  
2170 Whitehaven Road  
Grand Island, NY 14072  
716.773.6800

Global Engineering Solutions  
Plumbing  
6700A Rockledge Drive, Suite 301  
Rockville, MD 20850  
301.216.2871

LaFleur Associates, LLC  
Lighting  
307 High Street, Suite D  
Chesterton, MD 21620  
410.323.1420

Anthony James Partners  
Multi-Media / Audio Visual / Acoustics  
3900 Westere Parkway, Suite 300  
Richmond, VA 23233  
804.727.0070

Culinary Advisors  
Food Service  
3734 Cross Bow Court  
Ellicott City, MD 21042  
410.750.9467

Koffel Associates, Inc.  
Fire Protection  
8815 Centre Park Drive  
Columbia, MD 21045  
410.750.2246

ISSUED FOR:

RECORD SET

| REV | DATE      | DESCRIPTION |
|-----|-----------|-------------|
| 1   | 5/20/2016 | CDC-006     |
|     |           |             |
|     |           |             |
SCALE: As Indicated

DATE: 10/15/2018

SHEET TITLE:

RIGGING PLAN

S104